Exhibit C

CYO

"AS-BUILT" print supplied by Const. Management 6/9/88

LAKE ERIE

RECREATION HALL

EXISTING SEWER BREAK

EXIST MAN HOLE - FILL & PLUG

6" EXIST SAN SEWER

FILL & PLUG

INV. 626.3

AREA OF EXISTING BANK WASH OUT

TIE IN NEW 6" SAN @ INV ELE RIM 630.6

622.6

24" SEWER

CUT & CAP EXIST WATER LINE

VALVE NEW 2" @ TIE IN

2" EXIST WATER

WATER SERVICE TO ADJOINING PROPERTY

EXIST SAN SEWER

EXIST. SAN SEWER

GAS

THIS CABIN TO BE RELOCATED SEE DWG SP-2 FOR LOCATION & FOUNDATION DETAILS

CABIN "A"

VACATE EXISTING WATER PIT & FILL WITH SAND

EXIST WATER PIT FILL W/ SAND

2" EXIST WATER

6" EXIST SAN SEWER

CABIN "B"

THIS CABIN TO BE RELOCATED SEE DWG SP-2 FOR NEW LOCATION & FOUNDATION DETAILS.

EXIST. 6" SAN SEWER

NEW 6" SAN SEWER

CUT & CAP EXIST WATER LINE @ THIS LOCATION BOTH BLDG

EXISTING M.H. - FILL

OLD 6" SEWER

GAS

APPROX LOCATION OF EXIST. GAS LINE

EXIST GAS WATER PIT

CONN WATER TO EXIST LINE

NEW WATER LINE TO CABIN "C"

PLUG EXIST. 6" SEWER

CABIN "C"

10'-0"

4'-0"

16'-0"

MAIN. BLDG.

NEW 6" SAN. SEWER

NEW PRE CAST CONCRETE MANHOLE W/ C.I. COVER

NEW 6" SAN. SEWER

PLUG EXIST SAN SEWER

NEW ELEC SUPPLY TO POOL

NEW 2" WATER - 4' DEEP

7'-0"

NEW 6" SAN. SEWER

TIE IN EXIST POOL DRAIN.

NEW PRE CAST CONC MAN HOLE W/ CAST IRON COVER

CAP EXIST SEWER

CUT & CAP EXIST WATER LINE

SEE DETAIL 'A' THIS SHT FOR VALVE LAYOUT

EXIST ELECTRICAL POOL

NEW VALVE PIT & COVER

6'-0"

EXIST. SAN SEWER

EXIST 3/4 WATER

NEW 2" WATER LINE

TIE EXIST POOL LINE TO NEW 2" LINE W/ VALVE ON POOL LINE

NEW VALVE PIT & COVER

APPROX LOCATION OF EXIST GAS LINE

NOTE: THIS LINE WAS INSTALLED 1-88 & TRENCH WAS VISABLE ON SITE

MAIN DRIVE

CUT & CAP EXISTING WATER

EXIST WATER PIT FOR VATICAN & HOUSE

EXIST WATER

CAPED EXIST — VACATED LINE

TO CABIN "2"

NEW 2"

EXISTING TO SOUTH & WEST CABINS EXCEPT CABIN "C"

DETAIL "A"

TENNIS COURT

TO VATICAN & HOUSE

POOL

EXIST. SAN SEWER

EXIST. 3/4" WATER

EXIST WATER TO CABINS & SHOWER BLDG. 2

EXIST WATER TO CABINS & SHOWER

EXIST MANHOLE
RIM. ELEV. 633.7
INV. ELEV. 628.7

MATCH LINE

MATCH LINE

NOTES

1. ALL SEWER LINES TO BE INSTALLED TO ALL LOCAL, COUNTY & STATE CODES GOVERING THIS WORK
2. IT WILL BE THE RESPONSIBILITY OF THE SEWER CONTRACTOR TO CALL FOR INSPECTION & PAY ALL FEES REQUIRED FOR INSPECTION
3. ALL FOUNDATIONS FOR RELOCATED CABINS TO BE IN ACCORDANCE WITH ALL LOCAL, COUNTY & STATE CODES

SITE PLAN

SCALE 1" = 20'-0"

revisions 6/9/88

Construction Management Consultants, Inc.
19451 Rockland Avenue
Cleveland, Ohio 44117
(216) 531-0161

drawings: SEWER, WATER & CABIN RELOCATION SITE PLAN

commission no. 8810

date 3-25-88 | drawn by HS SCS

title: C.Y.O. CAMP ISSAC JOGUES
5505 CHAPEL ROAD
MADISON OHIO

CATHOLIC CHARITIES
CLEVELAND OHIO

sheet no. SP-1
SHT 1 OF 2

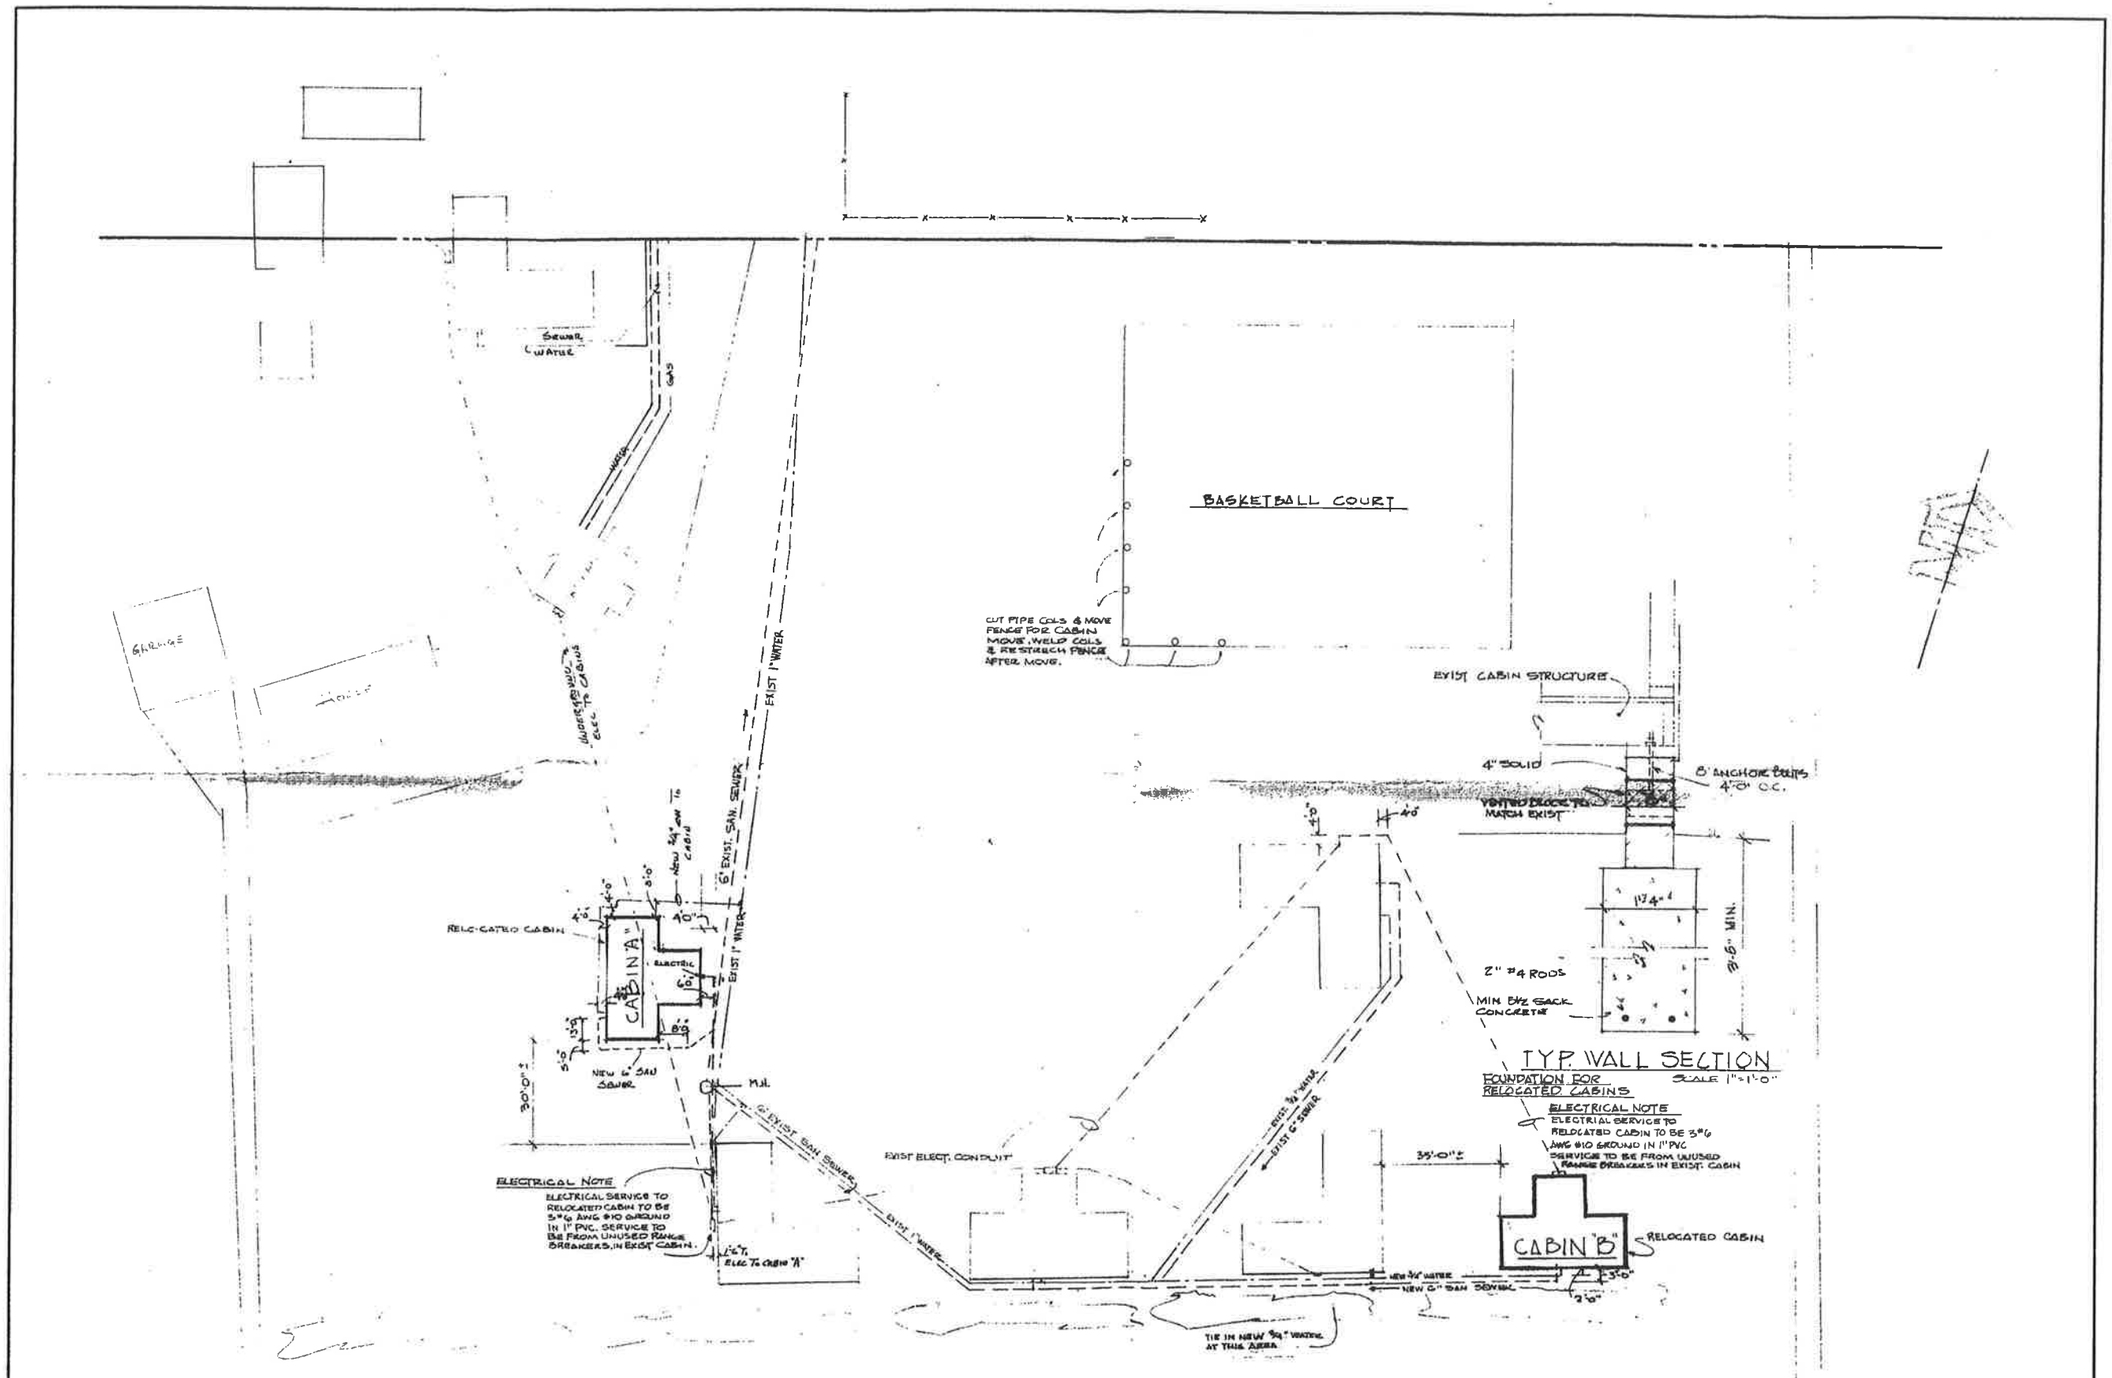

SITE PLAN (CON'T)

SCALE 1" = 20'-0"

SEWER CLEANOUTS BENEATH EACH CABIN

revisions 6/9/88

Construction Management Consultants, Inc.
19451 Roseland Avenue
Cleveland, Ohio 44117
(216) 531-0161

drawings SEWER & WATER FOUNDATION DETAILS

commission no. 8610

date 3-25-88

drawn by J.E. SOJA

title C.Y.O. CAMP ISSAC JOGUES
5585 CHAPEL ROAD
MADISON OHIO
CATHOLIC CHARITIES
CLEVELAND OHIO

sheet no. SP-2
SHT 2 OF 2